




SURVEYOR'S CERTIFICATE

I, CLAYTON J. MARTIN, LS 7077, HEREBY CERTIFY THAT I AM A REGISTERED PROFESSIONAL LAND SURVEYOR IN THE STATE OF ALASKA, AND THAT THIS PLAT REPRESENTS A SURVEY MADE BY ME OR UNDER MY DIRECT SUPERVISION, AND THAT ALL THE MONUMENTS SHOWN ON THE PLAT EXIST AS DESCRIBED, AND THAT ALL DIMENSIONAL AND OTHER DETAILS ARE TRUE AND CORRECT TO THE BEST OF MY KNOWLEDGE.

284.54' - RECORD
 BASIS OF BEARING-S-PLAT NO. 85-45 N89°58'12"W 285.02' - MEASURED

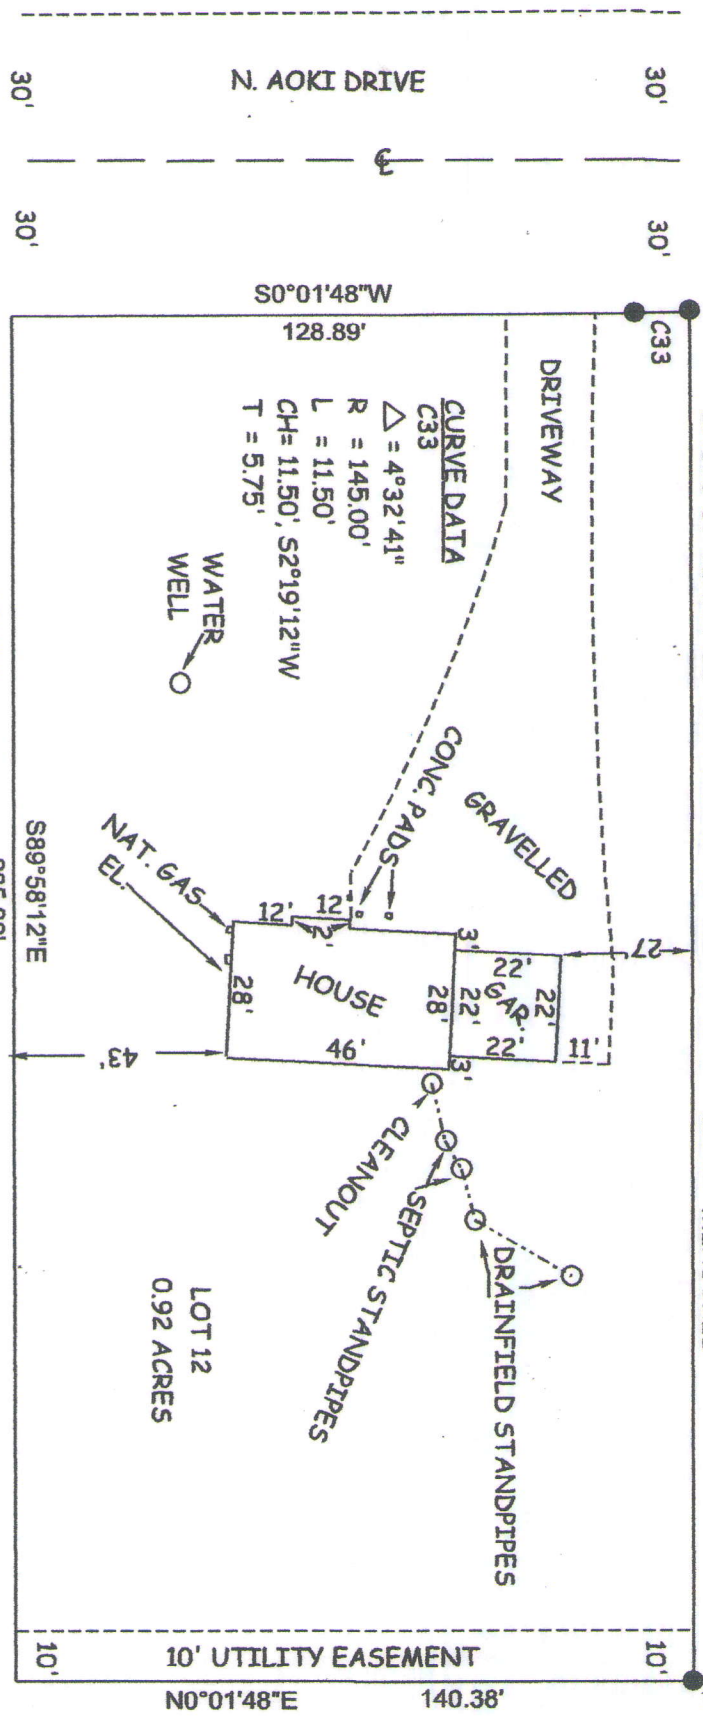

LEGEND
 ● = 5/8" IRON ROD
 ○ = AS NOTED

REFERENCES
 PLAT NO. 85-45
 DOC NO. 2009-016254-0

AS-BUILT SURVEY FOR PACIFIC NORTH CONST. INC.
 IN TRACT C, MEMORY LAKE COMMERCIAL SUB. BLOCK 2, LOT 12
 PLAT NO. 85-45
 SW1/4, SEC. 25, T. 18 N., R. 1 W., S.M., ALASKA.
 0.92 ACRE

SCALE: 1" = 40'
 SEP. 24, 2009