


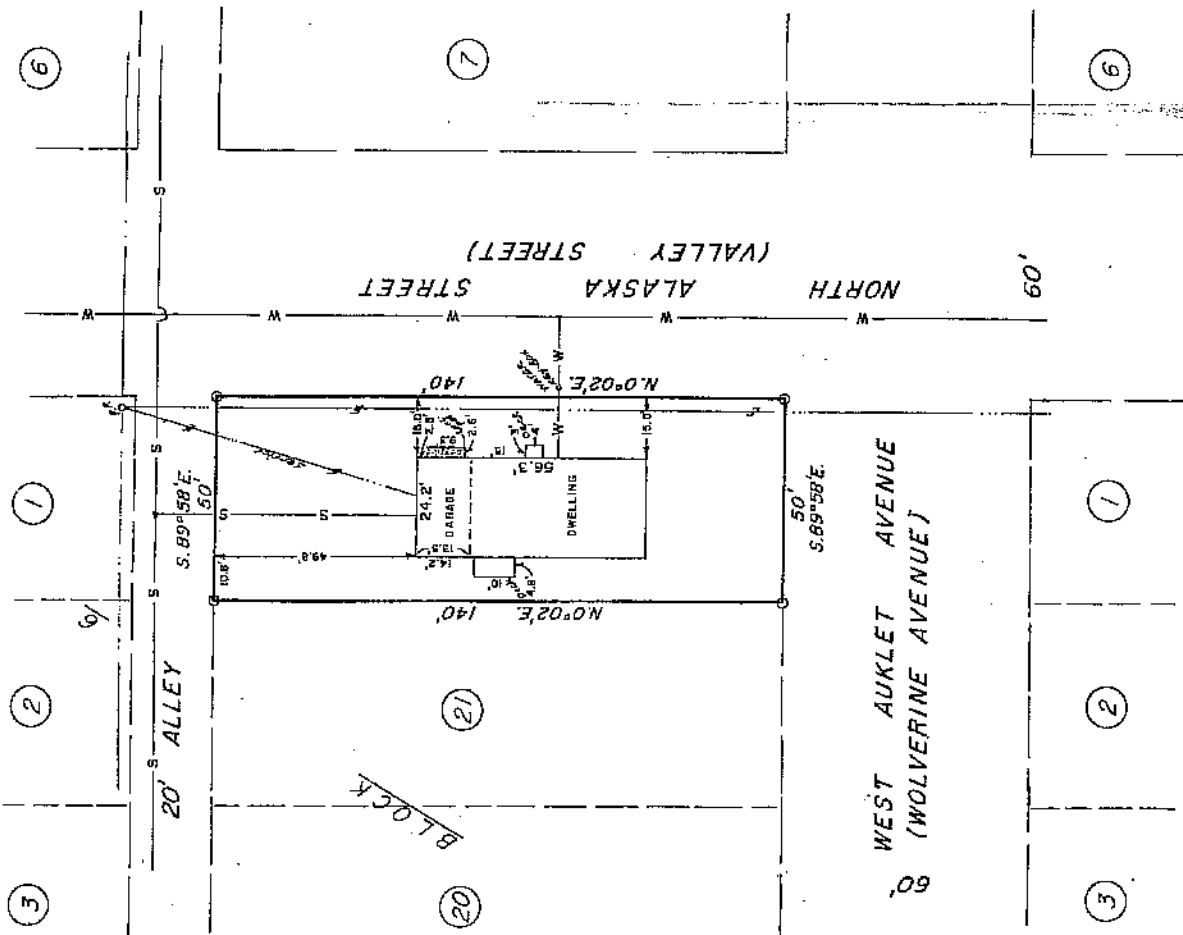

REFERENCE: REVISED PLAT OF THE T.A. SMITH SUBDIVISION
PLAT FILE NO. 64-6, Palmer Recording District.

NOTES:

1. Dwelling is frame construction on all-weather wood foundation and concrete footings. Attached garage is on a concrete slab.
2. The property is served by City of Palmer water and sewer. The locations of these underground facilities as shown is approximate, except for the water key-box which was located this survey.

AS-BUILT SURVEY & PLOT PLAN
LOT 22, BLOCK 6

T.A. SMITH SUBDIVISION (REVISED)

SCALE: 1" = 30'	APPROVED BY	DRAWN BY
DATE: 10/27/82		H.M.C.
CAMPBELL SURVEYING		
Harry M. Campbell, Jr., L.S.		
P. O. Box 721 Palmer, Alaska 99645		
Phone (907) 745-4157		
DRAWING NUMBER		82-33