


FOR DEC USE
AND FOR REFERENCE
PURPOSES ONLY

RECEIVED
FEB 19 1988
ENGINEERS & SURVEYORS
ALASKA

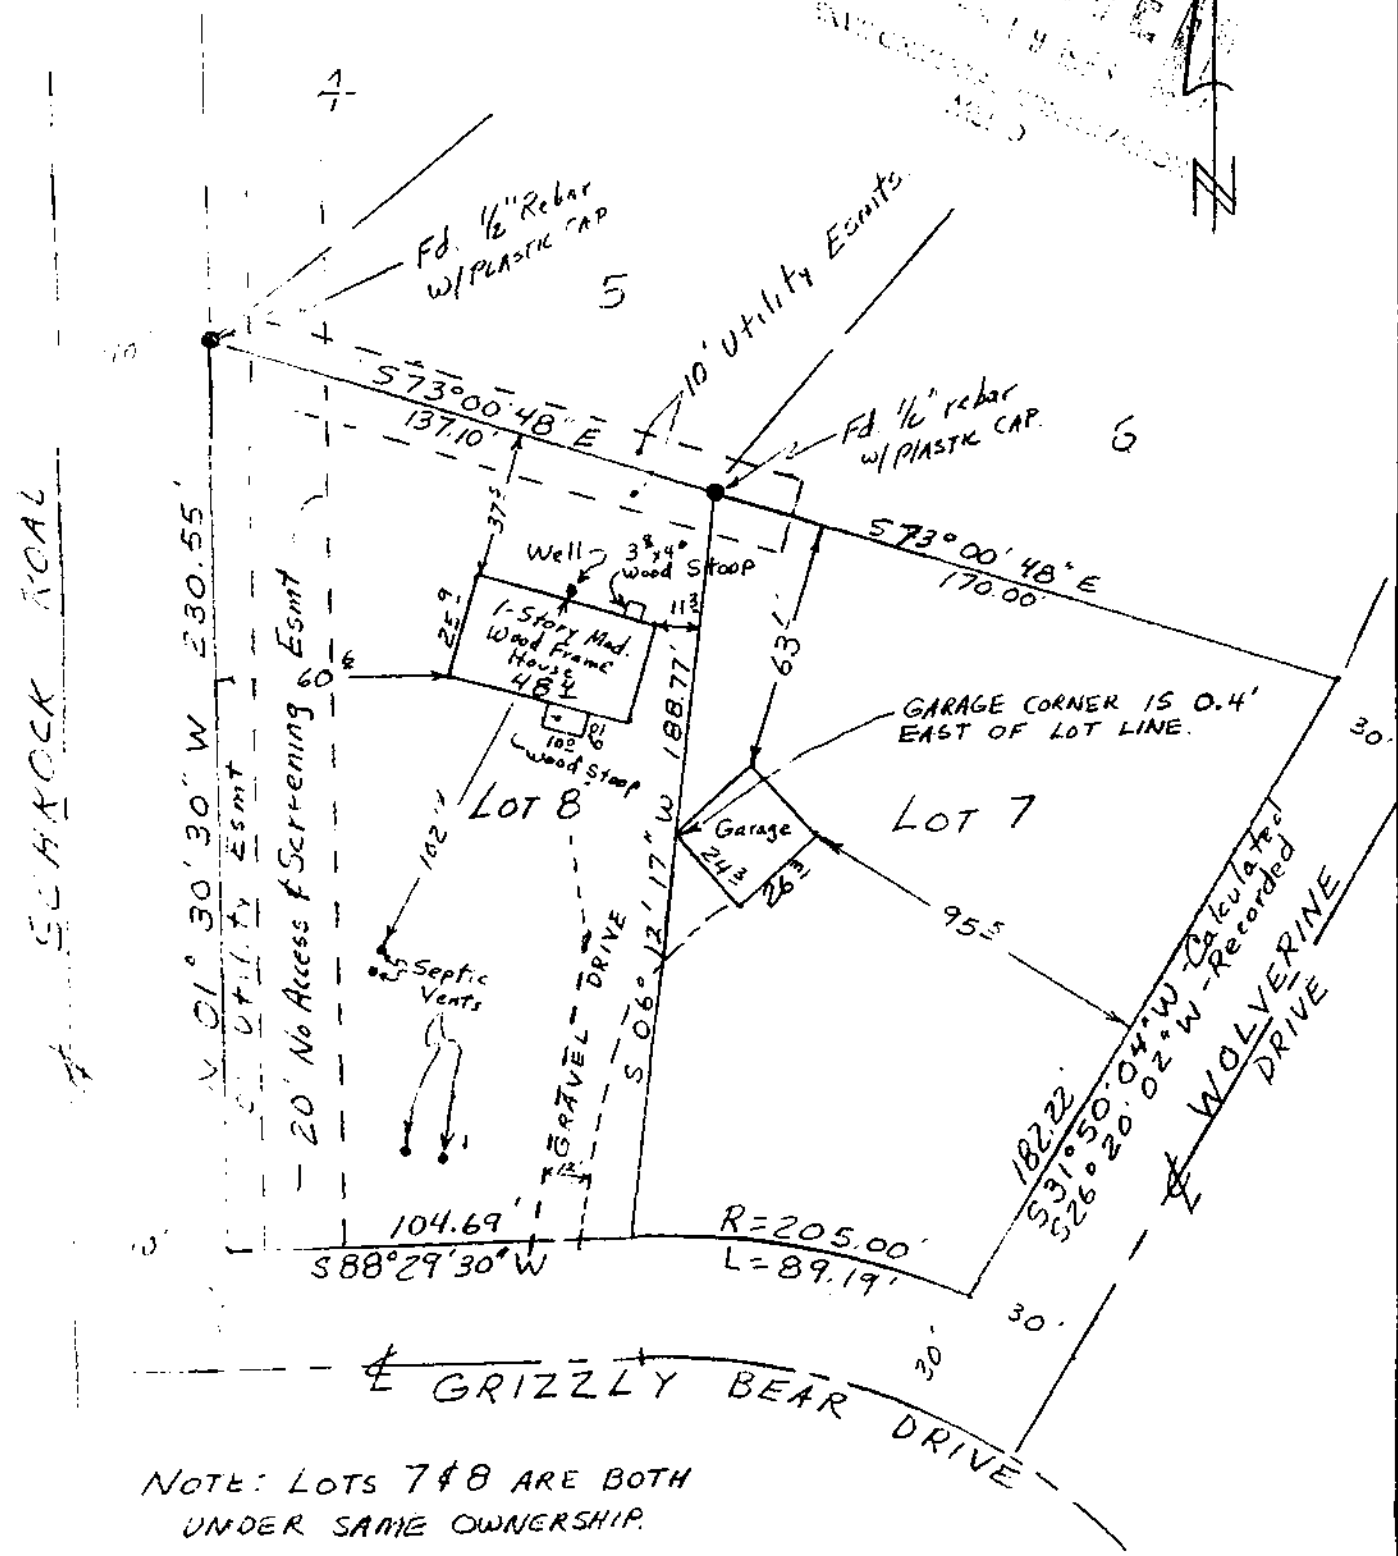

NOTE: LOTS 7 & 8 ARE BOTH
UNDER SAME OWNERSHIP.

AS-BUILT SURVEY of:
LOTS 7 & 8, BLK 3, MEMORY LAKE EST. #1

JOB NO.: 7624
CLIENT: Continental
FIELD BOOK: Ventures

SCALE 1" = 50' PLOT PLAN: AS-BUILT: X MAP: DRAWN BY: CLT CHECKED BY:

DENALI ENGINEERS & SURVEYORS

P.O. BOX 873447
WASILLA, ALASKA 99687

I HEREBY CERTIFY THAT THE IMPROVEMENTS SITUATED ON LOTS 7 & 8 BLOCK 3
MEMORY LAKE EST. #1 PALMER RECORDING DISTRICT, AK. ARE WITHIN THE
PROPERTY LINES AND DO NOT ENCRONCH ON THE PROPERTY LYING ADJACENT THERETO.
THAT NO IMPROVEMENTS ON PROPERTY LYING ADJACENT THERETO ENCRONCH ON THE
PREMISES IN QUESTION AND THAT THERE ARE NO ROADWAYS, TRANSMISSION LINES
OR OTHER VISIBLE EASEMENTS ON SAID PROPERTY EXCEPT AS INDICATED HEREON.

DATED THIS 17TH DAY OF FEBRUARY, 1988, WASILLA, ALASKA

IT IS THE RESPONSIBILITY OF THE OWNER OR BUILDER, PRIOR TO CONSTRUCTION,
TO VERIFY PROPERTY LINES AND PROPOSED BUILDING GRADE RELATIVE TO FINISH
GRADE AND UTILITY CONNECTIONS AND TO DETERMINE THE EXISTENCE OF ANY
EASEMENTS, COVENANTS OR RESTRICTIONS WHICH DO NOT APPEAR ON THE RECORDED

