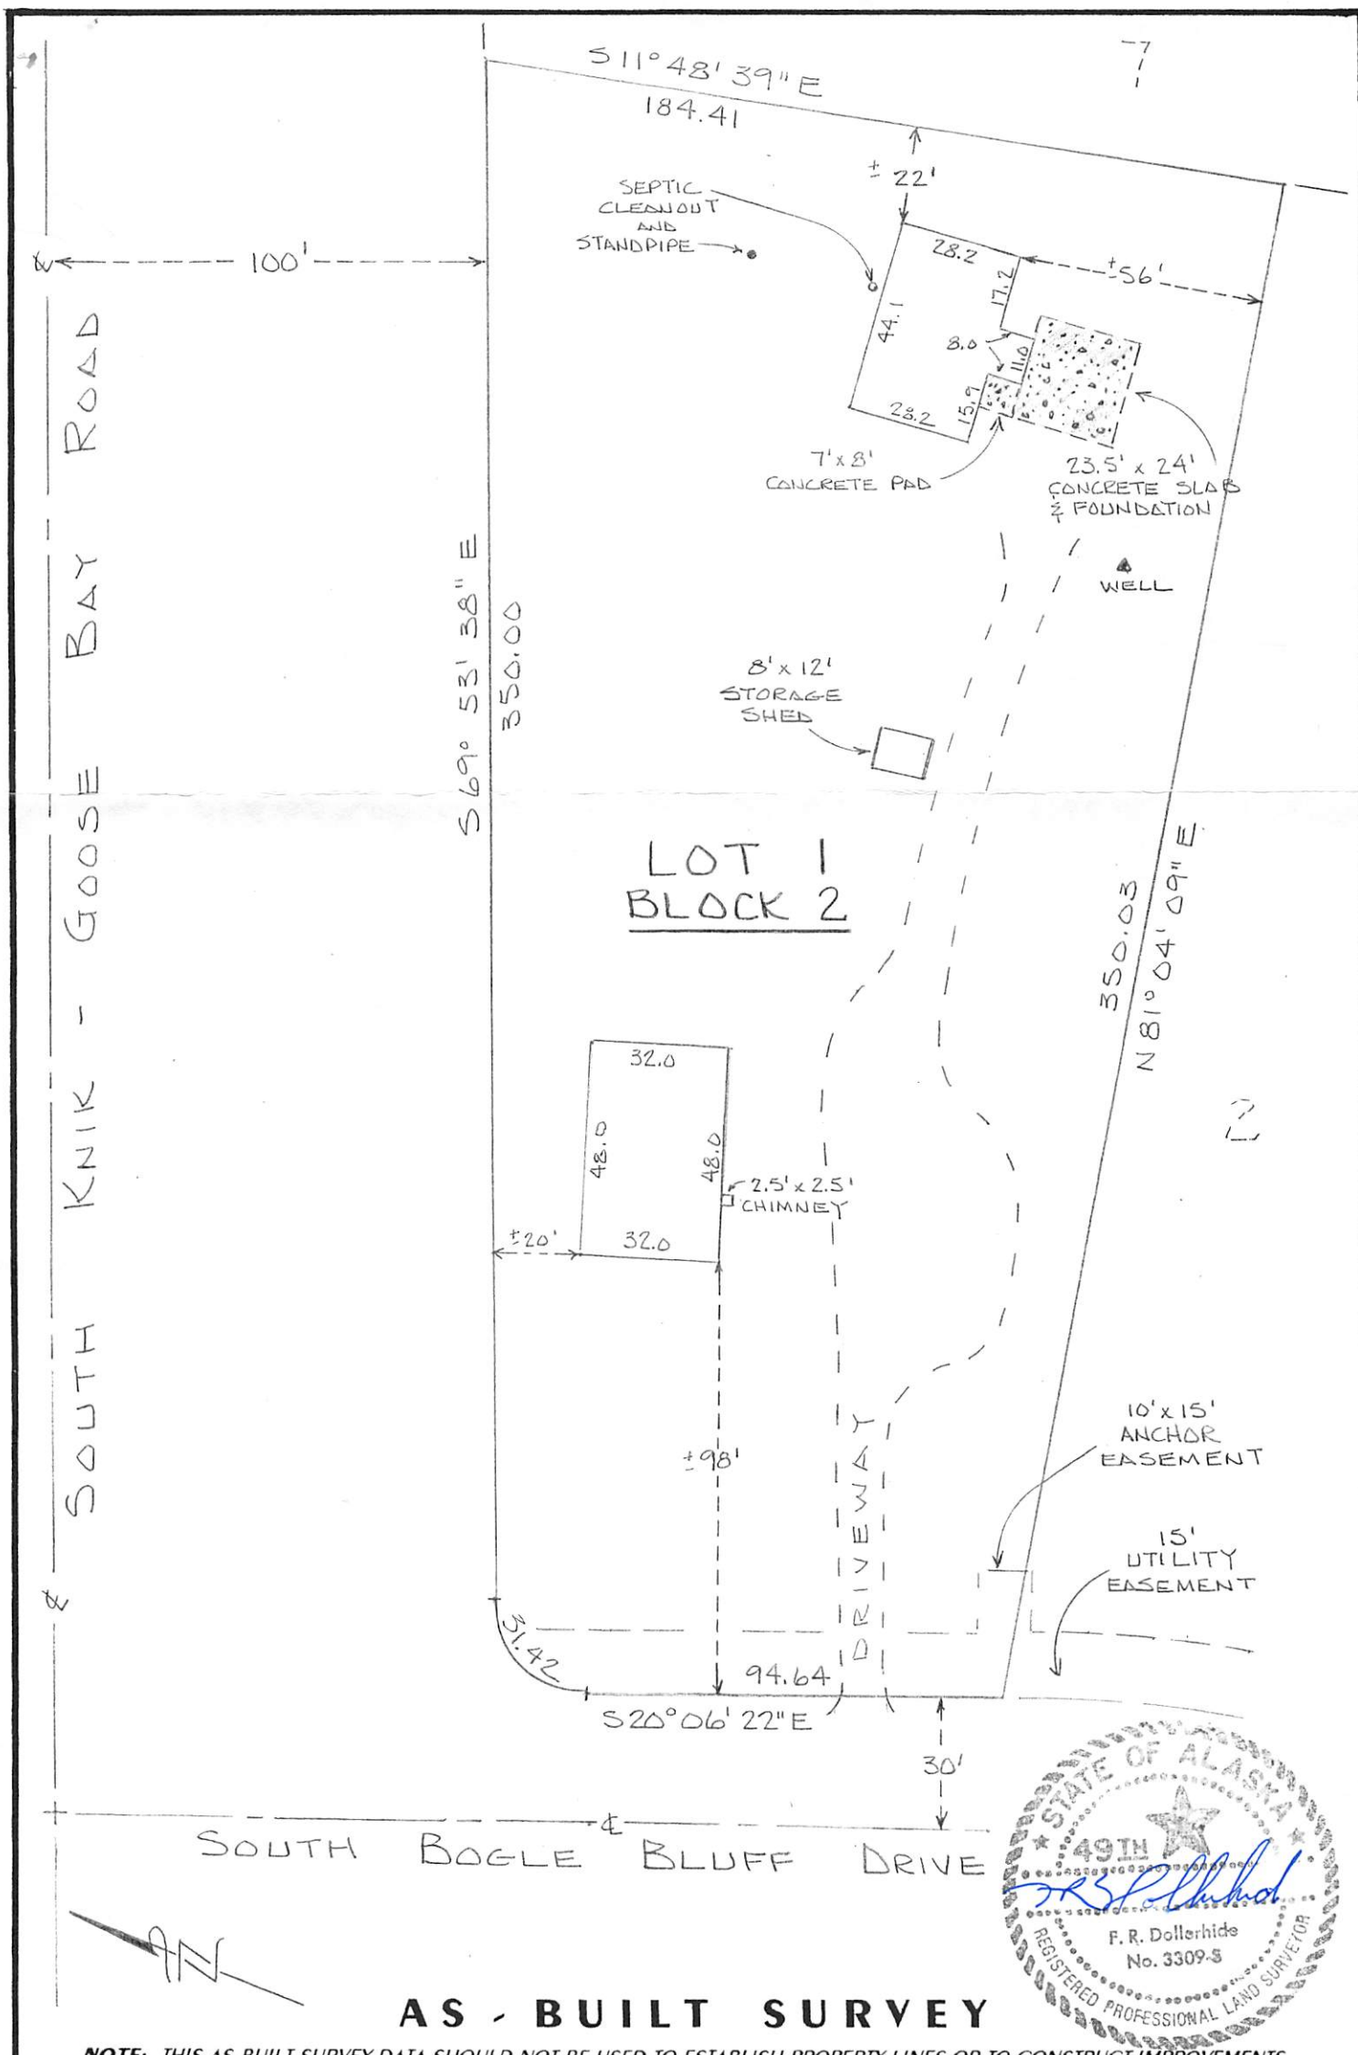

AS - BUILT SURVEY

NOTE: *THIS AS-BUILT SURVEY DATA SHOULD NOT BE USED TO ESTABLISH PROPERTY LINES OR TO CONSTRUCT IMPROVEMENTS.*

SCALE : 1" = 40'

DATE : FEB. 16, 2005

LOT 1 BLOCK 2
INLET VIEW SUBDIVISION

PLAT NO. 82 - 039

PALMER RECORDING DISTRICT

DOLLERHIDE ENGINEERING
POST OFFICE BOX 871812
WASILLA, ALASKA 99687
907/376-5485 FAX 373-1882